


REVISIONS				
REV	DESCRIPTION	DATE	DRWN	APPR
A	FINAL DESIGN RELEASE	6/11/21	BDS	ACM

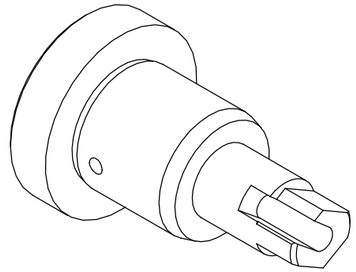

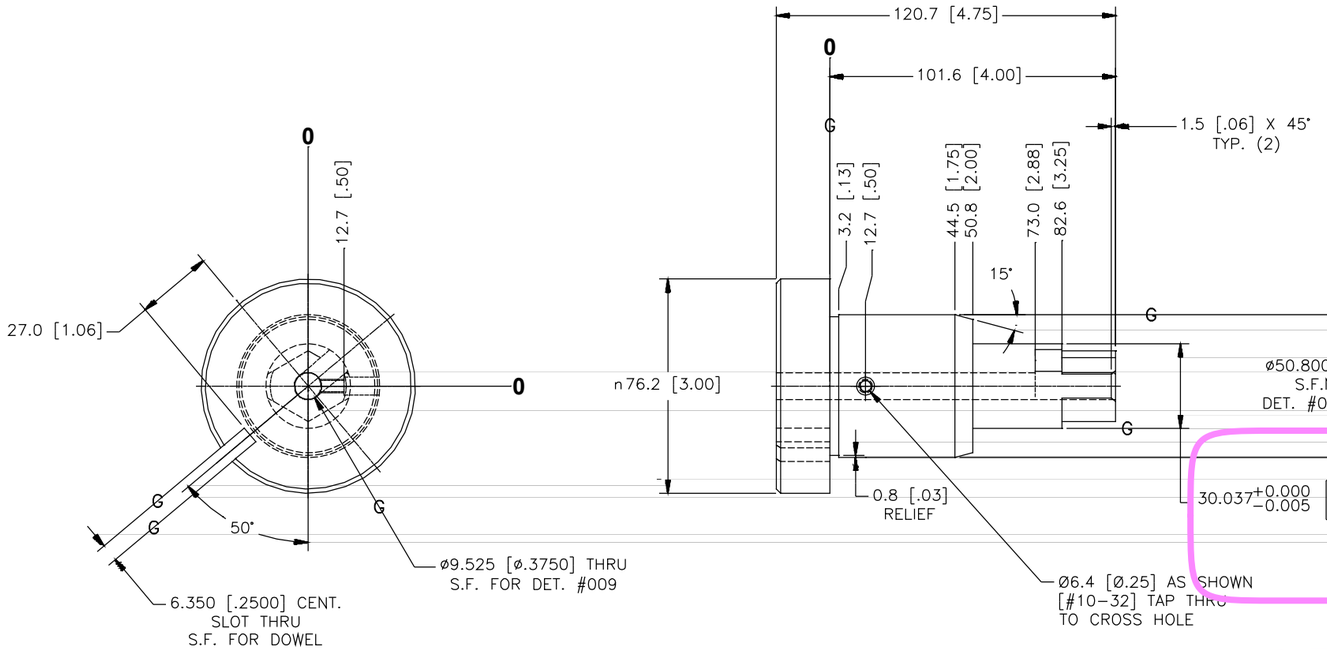

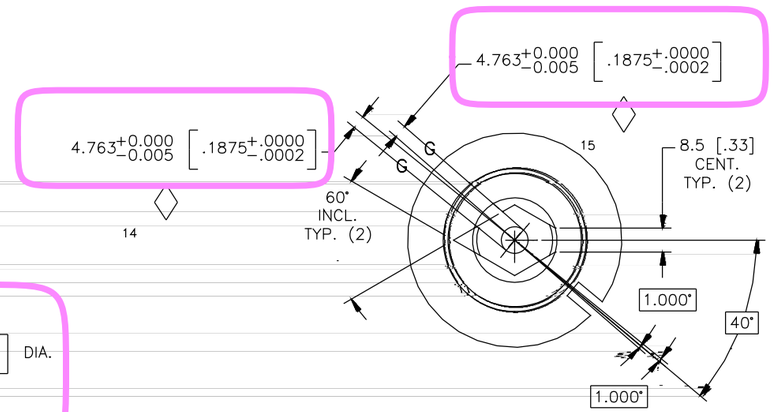

NOTE:
ALL GROUND SURFACES TO BE CONC. & SQ. AS APPLICABLE W/IN 0.005 [.0002]

12

NOTES:
1. BREAK ALL SHARP EDGES
2. ALL FINISHES TO BE 63ARA MAX UNLESS OTHERWISE SPECIFIED
3. CATAGORY: 90
4. PREVIOUSLY 90–100042

NOTE: BLACK OXIDE ALL NON GAGING SURFACES

Quench & Temper

JUS-RITE DETAIL CALLOUT							
DET	QTY.	DESCRIPTION	PART NUMBER	MATERIAL	HEAT TREAT	ROCKWELL	NOTES
007	1	BODY	201581-D007	~~8620~~ A2	~~CARB. HARDEN~~ BODY	58–62	GRIND

PROPRIETARY AND CONFIDENTIAL
THE INFORMATION CONTAINED IN THIS DRAWING IS THE SOLE PROPERTY OF JUS-RITE ENGINEERING. ANY REPRODUCTION IN PART OR AS A WHOLE WITHOUT THE WRITTEN PERMISSION OF JUS-RITE ENGINEERING IS PROHIBITED.

UNLESS OTHERWISE SPECIFIED DIMENSIONS ARE IN INCHES
TOLERANCES:
ANGULAR: ± 1°
TWO PLACE DECIMAL: ±.010
THREE PLACE DECIMAL: ±.005

DRAWING DATE: 5/21/21
SHEET 010 OF 019

G&T PER:
MATERIAL:
FINISH:
VENDOR: 8620

TITLE: BODY
SIZE: D
DWG. NO.: 201581
REV: 1

3.60 lbmass

Green Line Change No. 3