

REVISIONS				
REV	DESCRIPTION	DATE	DRWN	APPR
A	FINAL DESIGN RELEASE	6/11/21	BDS	ACM

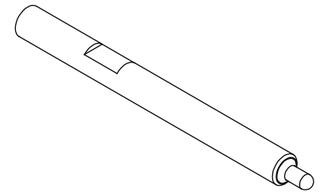

VIEW SHOWN
SCALE 1 : 1

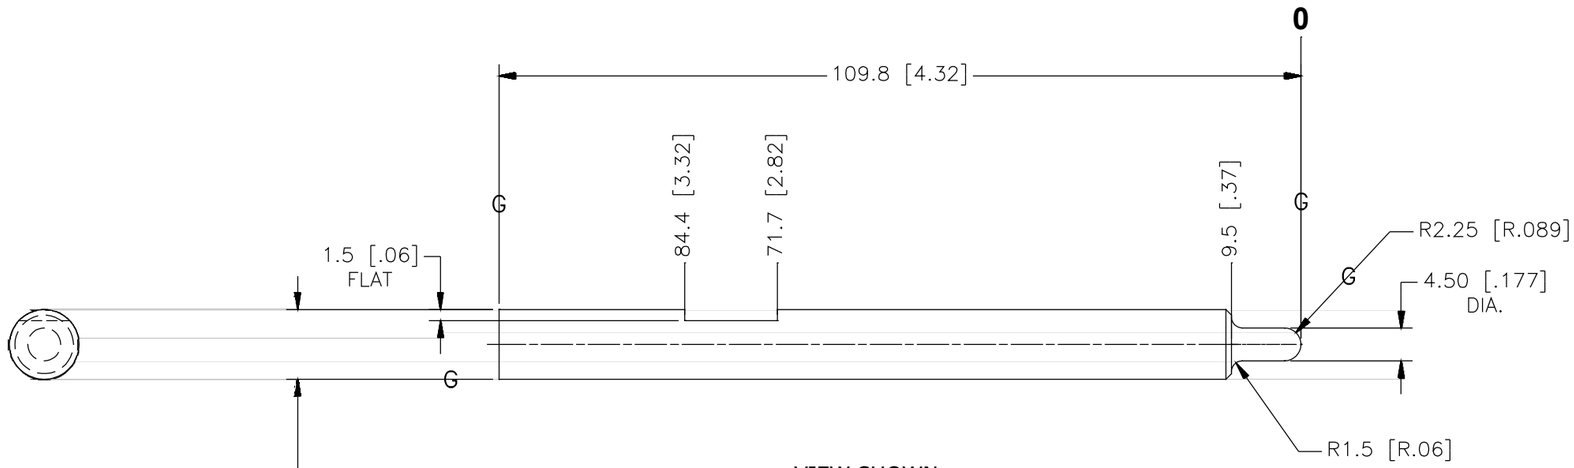

VIEW SHOWN
SCALE 2 : 1

Green Line Change No. 4
Changed material from O-6 to Reamer Blank bc it's already hardened and ground

NOTE: BLACK OXIDE ALL NON GAGING SURFACES

NOTES:
1. BREAK ALL SHARP EDGES
2. ALL FINISHES TO BE 63ARA MAX UNLESS OTHERWISE SPECIFIED
3. CATAGORY: 90
4. PREVIOUSLY 90-100042

JUS-RITE DETAIL CALLOUT							
DET	QTY.	DESCRIPTION	PART NUMBER	MATERIAL	HEAT TREAT	ROCKWELL	NOTES
008	1	PIN	201581-D008	Reamer Blank ~~O6~~	~~HARDEN~~ PIN	60-64	GRIND

PROPRIETARY AND CONFIDENTIAL
THE INFORMATION CONTAINED IN THIS DRAWING IS THE SOLE PROPERTY OF JUS-RITE ENGINEERING. ANY REPRODUCTION IN PART OR AS A WHOLE WITHOUT THE WRITTEN PERMISSION OF JUS-RITE ENGINEERING IS PROHIBITED.

DRAWING DATE 5/21/21

UNLESS OTHERWISE SPECIFIED DIMENSIONS ARE IN INCHES
TOLERANCES:
ANGULAR: ± 0.5
TWO PLACE DECIMAL ± 0.010
THREE PLACE DECIMAL ± 0.005

SHEET 011 OF 019

GDLT PER:
MATERIAL 0.12 lbmass
FINISH
WEIGHT 06

TITLE: PIN

SIZE	DWG. NO.	REV
C	201581	1