



REVISIONS				
REV	DESCRIPTION	DATE	DRWN	APPR
A	FINAL DESIGN RELEASE	6/11/21	BDS	ACM

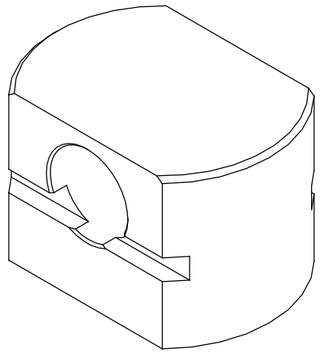

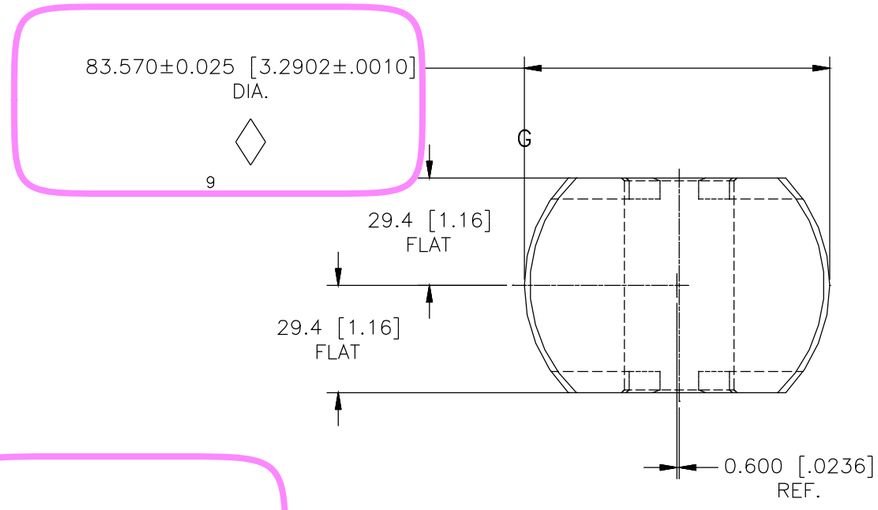

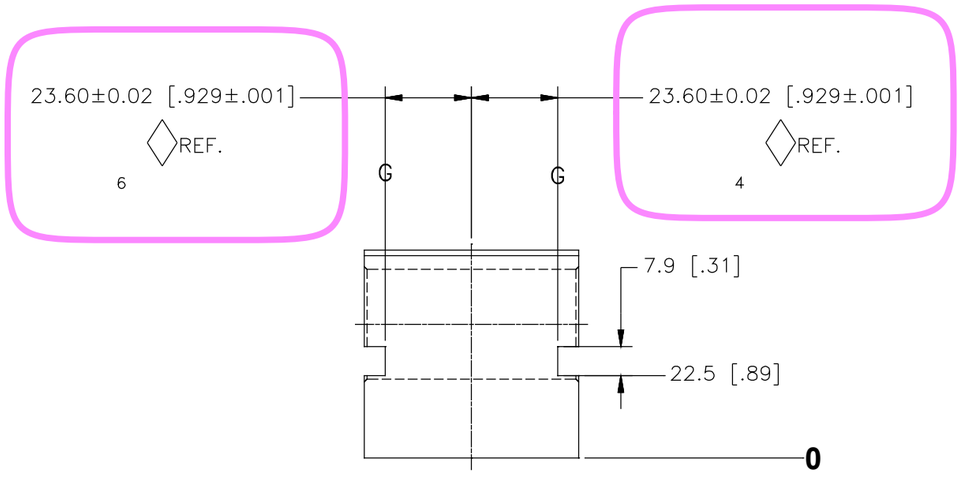

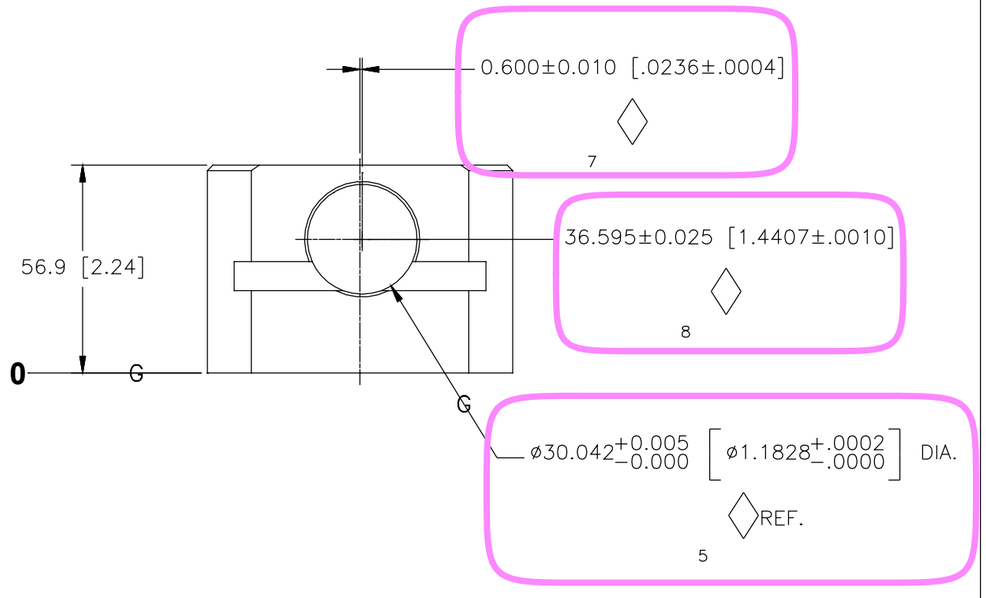

NOTE: BLACK OXIDE ALL NON GAGING SURFACES

NOTES:
1. BREAK ALL SHARP EDGES
2. ALL FINISHES TO BE 63ARA MAX UNLESS OTHERWISE SPECIFIED
3. CATAGORY: 90
4. PREVIOUSLY 90-100042

JUS-RITE DETAIL CALLOUT

DET	QTY.	DESCRIPTION	PART NUMBER	MATERIAL	HEAT TREAT	ROCKWELL	NOTES
016	1	MEAN MASTER	202001	~~8620~~ A2	CARB. HARDEN Quench & Temper	58-62	GRIND

PROPRIETARY AND CONFIDENTIAL
THE INFORMATION CONTAINED IN THIS DRAWING IS THE SOLE PROPERTY OF JUS-RITE ENGINEERING. ANY REPRODUCTION IN PART OR AS A WHOLE WITHOUT THE WRITTEN PERMISSION OF JUS-RITE ENGINEERING IS PROHIBITED.

DRAWING DATE 5/21/21

UNLESS OTHERWISE SPECIFIED DIMENSIONS ARE IN INCHES
TOLERANCES:
ANGULAR: ± .5
TWO PLACE DECIMAL ± .010
THREE PLACE DECIMAL ± .005

SHEET 019 OF 019

GDLT PER: N/A

MATERIAL ~~8620~~ MEAN MASTER

FINISH

WEIGHT

TITLE: C

SIZE | DWG. NO. 201581 | REV 1

Green Line Change No. 8